

WC PLAN NO
W.A.P.C. No.
FILE No.
F.T.I. DATE
LENGTH OF SEWERS
N° OF ACCESS CHAMBERS
N° OF MAINTENANCE SHAFTS
N° OF LOTS SERVED
CONTRACTOR

MU89-207-001-01A
155121
JT1 2018 00798 V01
25/05/2018
Ø150P - 28.6m
0
1
3
ECO PLUMBING & GAS

CONSULTING ENGINEER
MCDOWALL AFFLECK PTY LTD

DATE


Paul Nas
Paul Nas
2018.06.22 14:00:52 +08'00'

LICENSED SURVEYOR
NASTECH (WA) PTY LTD
T/AS THE LAND DIVISION

DATE

LEGEND

- LID RL
- ACCESS CHAMBER NUMBER
- ACCESS CHAMBER TYPE
- DROP ACCESS CHAMBER
- STANDARD R.C. COVER
- TRAFFICABLE COVER
- EXISTING SEWER MANHOLE
- EXISTING SEWER MAIN
- EXISTING HOUSE CONNECTION
- CONSTRUCTED SEWER MANHOLE
- CONSTRUCTED SEWER MAIN SHOWN
- CONSTRUCTED HOUSE CONNECTION
- CATCHMENT AREA

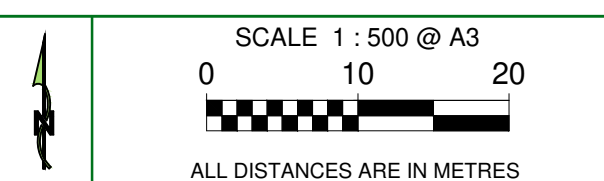

Title: Sewer Reticulation Plan - As Constructed

Project: 27 Wandoo Road, Forrestfield		
Local Authority: City of Kalamunda		
Datum: Local & AHD	Reticulation Area : N/A	
Client: Wong	Job Reference: 17-7309	
Scale: 1:500@A3	Revision:	
Surveyor	J. Duschka	1/5/2018
Drawn	J. Webb	22/6/2018
Checked	P. Nas	22/6/2018

PO Box 2444,
Malaga, WA 6090
Tel 089 209 3232
Fax 089 249 2551

THE LAND DIVISION
PLANNING | SURVEYING | DESIGN